(2)

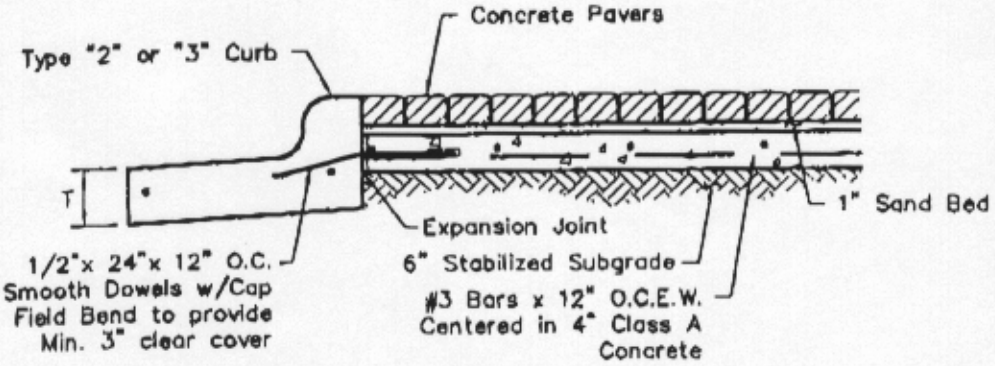

Concrete

(8-5/1

SECTION F-F

CONCRETE PAVER SIDEWALK ADJACENT TO CURB

(8-5,

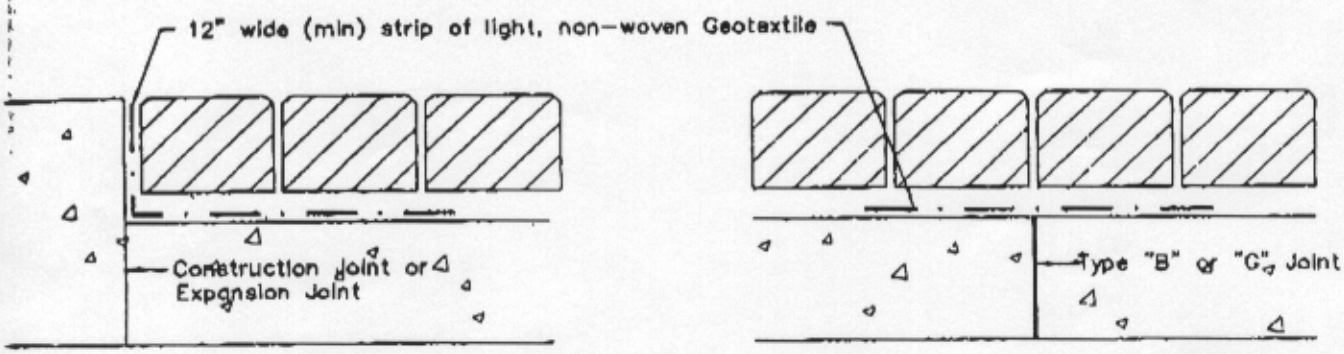

GEOTEXTILE FABRIC/JOINT DETAIL

See Sheet C14 for Additional Details

~~All~~ GEOTEXTILE FABRIC SHALL BE USED AT ALL ~~PREFORMED~~ JOINTS & All vert/horizontal Joint under ~~PAVERS~~ PAVERS

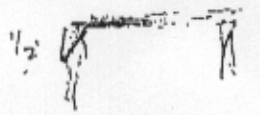

Note:
1. Unless other
are to the t
2. See Sht. C1
3. See Sht. C1

COORD

POINT NO.
34
35
49

NOTE
CAP MUST BE LONG ENOUGH TO COVER 2" OF THE DOWEL WITH ONE CLOSED END AND WITH A SUITABLE STOP TO HOLD THE END OF THE CAP AT LEAST 1" FROM THE END OF THE DOWEL BAR

Top of cap elevation

Geotextile Fabric

(3)

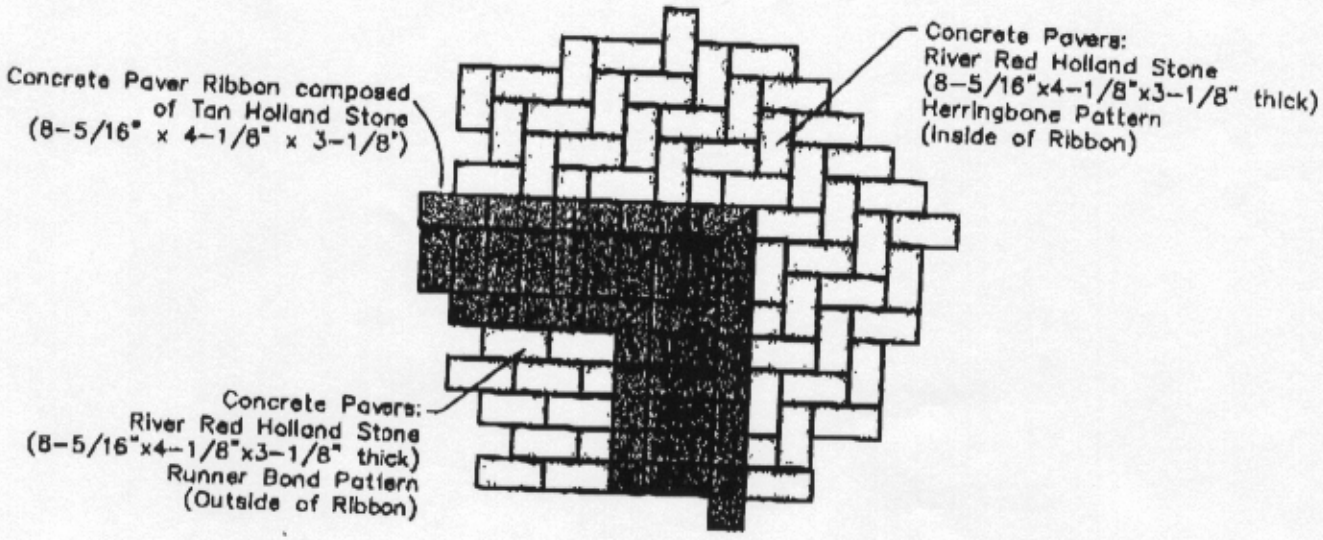

INSERT "A"

RIBBON DETAIL

Scale: 1" = 10'

+/horizontal Joints

Note:
1. Unless otherwise noted, all dimensions shown are to the back of curb.
2. See Sht. C14 for additional details.
3. See Sht. C14 for paving joint details.

COORDINATE CONTROL TABLE

POINT NO.	X COORD.	Y COORD.	TOP/CAP ELEV.
(34)	53826.32	68413.26	340.05

Street Light Coordinate Table